

MARCH 2, 2026

Town of Elizabethtown
7563 Court Street
Elizabethtown, New York 12932

AMENDMENT NO. 1 TO:

PROJECT: Noble Terrace over Barton Brook - Culvert Replacement

FEMA PROJECT NO.: 766429

IN THE LETTING OF
March 5, 2026 at 2:00 PM

NOTICE TO PROSPECTIVE BIDDERS

Project Manual

Replaced page II-27 & II-41 with the attached:

- Page II-27 – Itemized Bid Forms – Item 697.03, Field Change Payment has been revised.
- Page II-41 - DBE Percentage Requirements have been changed from 6% to 0%.

Construction Plans

Replace drawing no. ST-1, ST-19, & ST-20 with the updated drawings:

- ST-1 – Treatment of utility pole at northwest quadrant has been updated to be protected.
- ST-19 – Item 663.2300, End Polyethylene Encasement has been removed.
- ST-19 – PVC Water Main notes have been removed.
- ST-20 - Item 663.2300, End Polyethylene Encasement has been removed from the Waterworks Table.



PLEASE BE GOVERNED ACCORDINGLY WHEN SUBMITTING BIDS.

PLEASE FILL IN AND SIGN BELOW AND EMAIL THIS SHEET BACK TO THE
ESSEX COUNTY OFFICE OF THE PURCHASING AGENT AT

DANIEL.SADOWSKI@ESSEXCOUNTYNY.GOV

TO ACKNOWLEDGE RECEIPT OF THIS AMENDMENT

PLEASE CONTACT INESA PENGU WITH H&T ENGINEERING SERVICES, PLLC AT
(518) 500-2531 WITH ANY QUESTIONS.

Signed

Date

Representing

Thank you for your cooperation in this matter.

Brought Forward \$ _____.

ITEMIZED BID FORM							
ITEM DESCRIPTION	QTY	UNIT	UNIT PRICE IN WORDS			UNIT PRICE (NUMERALS)	TOTAL (NUMERALS)
647.51	REMOVE AND DISPOSE SIGN PANEL, SIGN PANEL ASSEMBLY SIZE I (UNDER 30 SQUARE FEET)	7	EACH	<hr/> Dollars <hr/> Cents			\$ _____ \$ _____
663.0508	BRIDGE MOUNTED WATER PIPE, 8"	110	LF	<hr/> Dollars <hr/> Cents			\$ _____ \$ _____
663.33	ADJUST EXISTING VALVE BOX ELEVATION	2	EACH	<hr/> Dollars <hr/> Cents			\$ _____ \$ _____
697.03	FIELD CHANGE PAYMENT	54820	DC	<u>FIXED PRICE SPECIFICATION</u>			Dollars \$ _____ 1.00 Cents \$ _____ 54,820.00

DISADVANTAGED BUSINESS ENTERPRISE UTILIZATION GOALS

NEW YORK STATE DEPARTMENT OF TRANSPORTATION

DISADVANTAGED BUSINESS ENTERPRISE

UTILIZATION REQUIREMENTS

The Department has established the following Women Business Enterprise (M/WBE) utilization goals for this contract. The goal is expressed as a percentage of the total bid price.

Disadvantage Business Enterprise Utilization Goal ~~6%~~ 0%

Information related to the current certification status of Disadvantaged Business Enterprises, can be obtained by contacting the:

NYS Department of Transportation
Office of Civil Rights
50 Wolf Road
POD 6-2
Albany, NY 12232
(518) 457-1128 or 457-1129

Disadvantaged Business Enterprise Officer


The Bidder shall designate and enter below the name of a Minority and Women Business Enterprise Officer who will have the responsibility for and must be capable of effectively administering and promoting an active Minority and Women Business Enterprise Program and who must be assigned adequate authority and responsibility to do so.

Bidder Designated Disadvantaged Business Officer _____
(Name, Title)


Telephone Number: _____

RETURN THIS PAGE WITH BID

PROJECT MANAGER: C. TUTUNJIAN
 CHECKED BY: I. PENGU
 DRAFTED BY: C. VICKERY
 CHECKED BY: I. PENGU
 DESIGNED BY: C. VICKERY

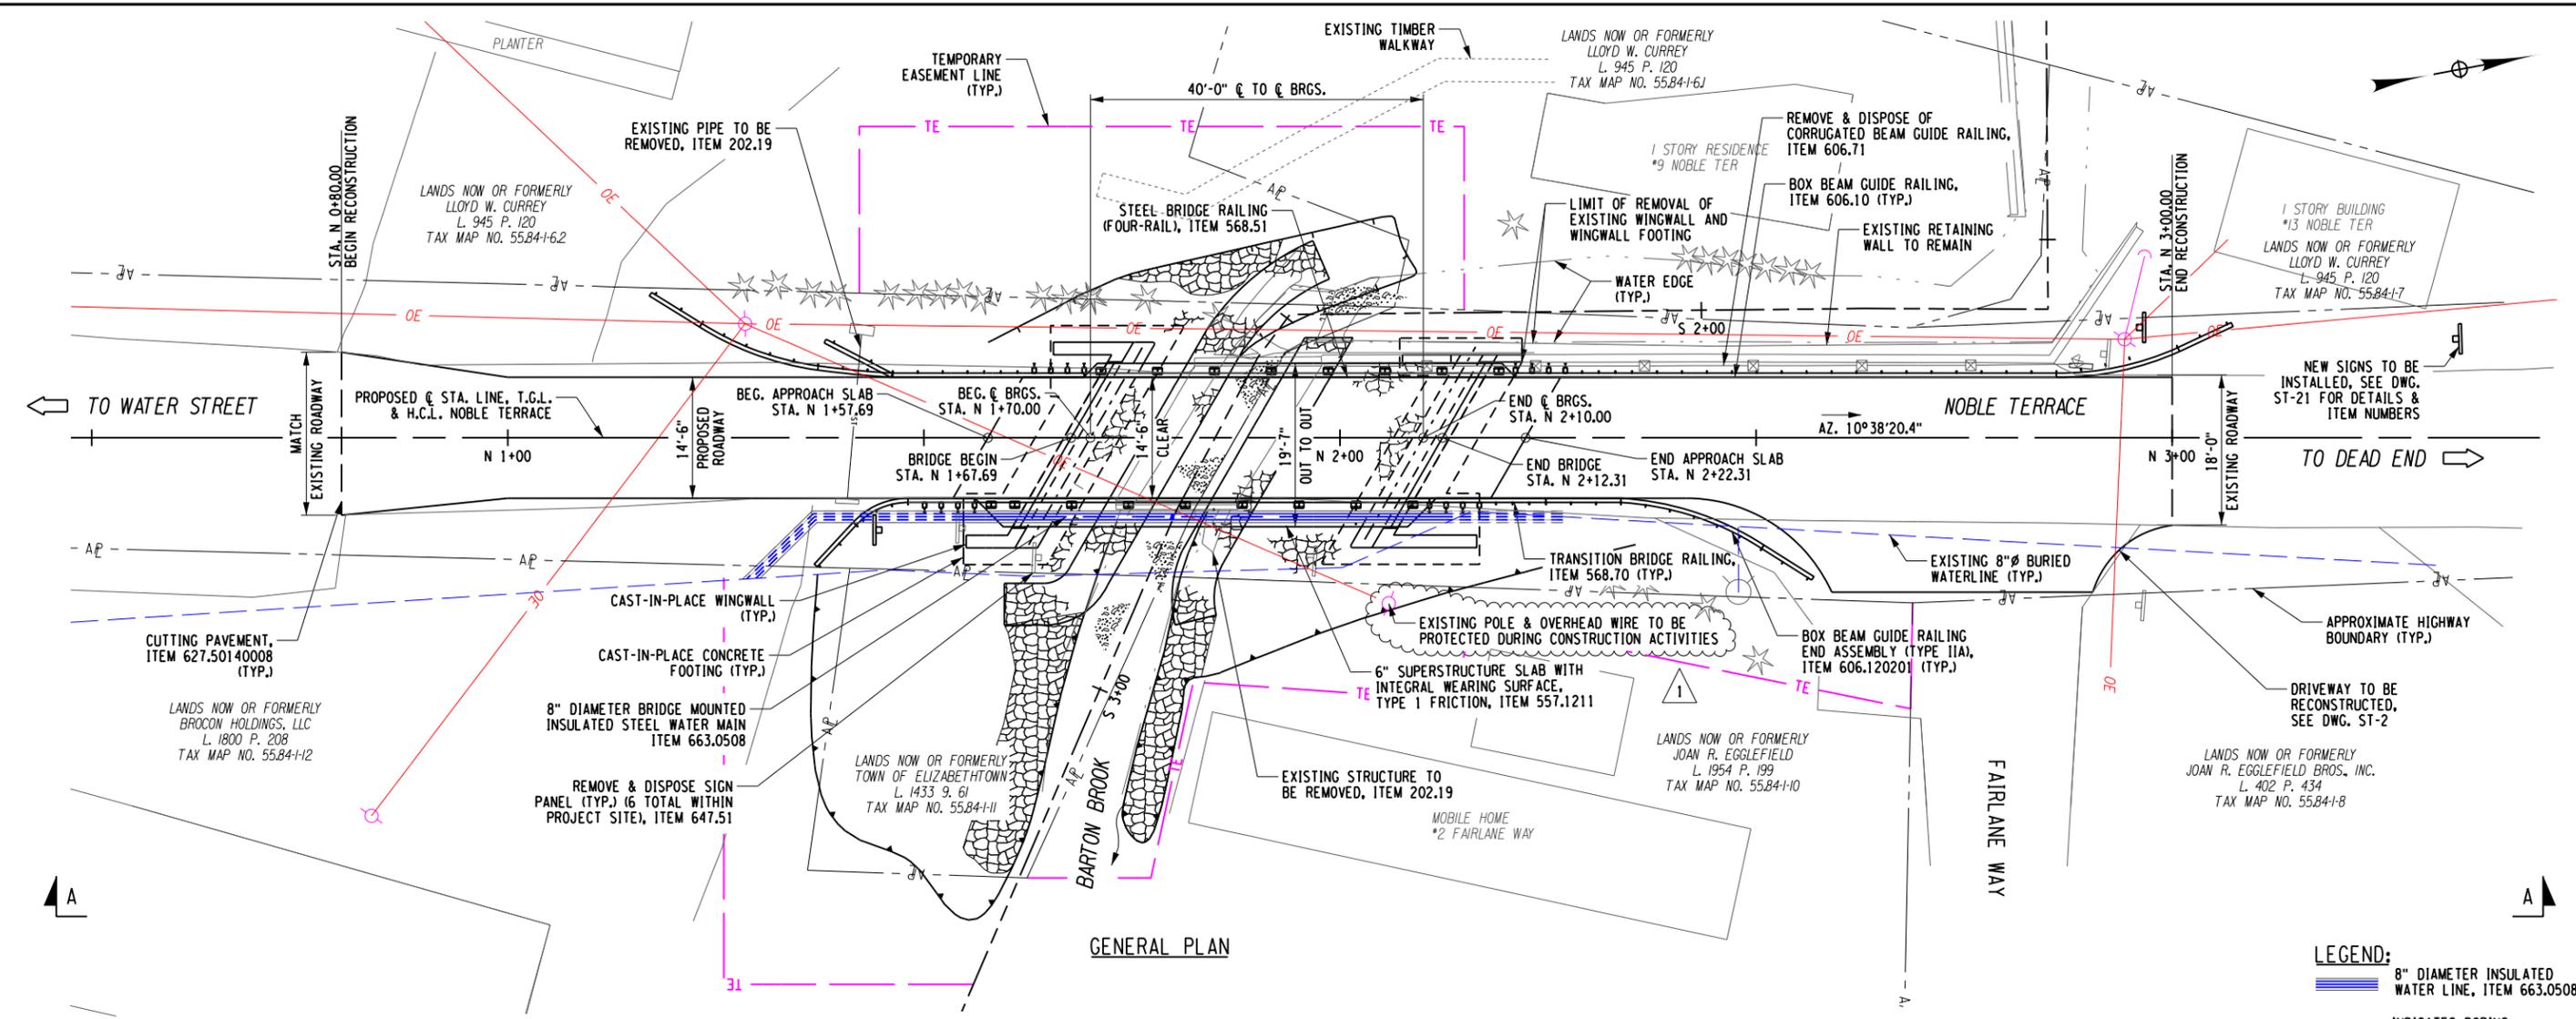


LOAD RATING (LFD)		
INVENTORY	HS-34	61.9 TONS
OPERATING	HS-45	82.4 TONS
LOAD RATING (LRFR)		
INVENTORY	HL-93	1.72
OPERATING	HL-93	2.29

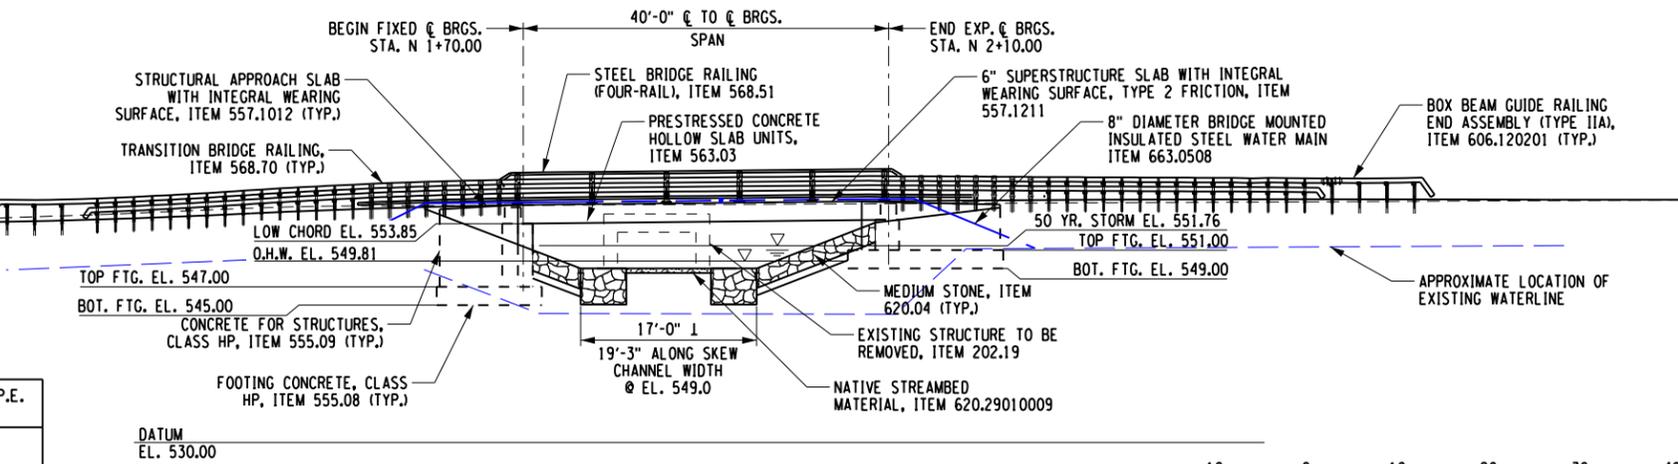

- LEGEND:**
- 8" DIAMETER INSULATED WATER LINE, ITEM 663.0508
 - INDICATES BORING LOCATION & DESIGNATION
 - STONE FILLING (MEDIUM), ITEM 620.04
 - NATIVE STREAMBED MATERIAL, ITEM 620.29010009
 - FILL LINE
 - CUT LINE

HYDRAULIC DATA			
DRAINAGE AREA	4.84 SQ. MILES	BASE FLOOD	DESIGN FLOOD
REQUENCY INTERVAL (YEARS)	100	50	
PEAK DISCHARGE (CFS)	572	495	
HIGH WATER ELEVATION AT POINT OF MAX. BACKWATER	EXISTING 556.60	PROPOSED 552.02	556.50
FREEBOARD PROVIDED (FT)	EXISTING -	PROPOSED 1.83	2.09
AVG. VELOCITY THRU STRUCT. @ DESIGN FLOOD	6.44 FT./SEC.		
SCOUR DEPTH: 2.0 FT	MINIMUM CHANNEL EL. 548.5 FT		
SCOUR DEPTH IS MEASURED FROM MINIMUM CHANNEL ELEVATION.			

PREPARED BY: CHARLES TUTUNJIAN, P.E. ON: 02/10/2026
 ALTERED BY: CHARLES TUTUNJIAN, P.E. ON: 03/02/2026

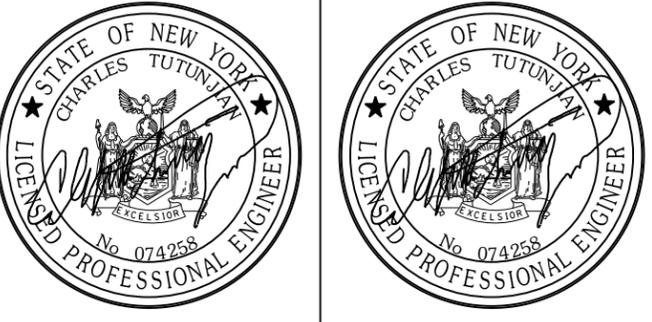


AS-BUILT REVISIONS DESCRIPTION OF ALTERATIONS:	NOBLE TERRACE OVER BARTON BROOK CULVERT REPLACEMENT PROJECT	BRIDGES BIN TBD	CULVERTS	ALL DIMENSIONS IN FT UNLESS OTHERWISE NOTED	CONTRACT NUMBER DR 4814 PROJECT NUMBER: 766429
	TOWN OF ELIZABETHTOWN			GENERAL PLAN & ELEVATION	DRAWING NO. ST-1
	COUNTY: ESSEX	REGION: 1			SHEET NO. 6

IT IS A VIOLATION OF LAW FOR ANY PERSON, UNLESS THEY ARE ACTING UNDER THE DIRECTION OF A LICENSED PROFESSIONAL ENGINEER, ARCHITECT, LANDSCAPE ARCHITECT, OR LAND SURVEYOR, TO ALTER AN ITEM IN ANY WAY. IF AN ITEM BEARING THE STAMP OF A LICENSED PROFESSIONAL IS ALTERED, THE ALTERING ENGINEER, ARCHITECT, LANDSCAPE ARCHITECT, OR LAND SURVEYOR SHALL STAMP THE DOCUMENT AND INCLUDE THE NOTATION "ALTERED BY" FOLLOWED BY THEIR SIGNATURE, THE DATE OF SUCH ALTERATION, AND A SPECIFIC DESCRIPTION OF THE ALTERATION.



PROJECT MANAGER: C. TUTUNJIAN
 CHECKED BY: I. PENGU
 DRAFTED BY: C. VICKERY
 DESIGNED BY: C. VICKERY

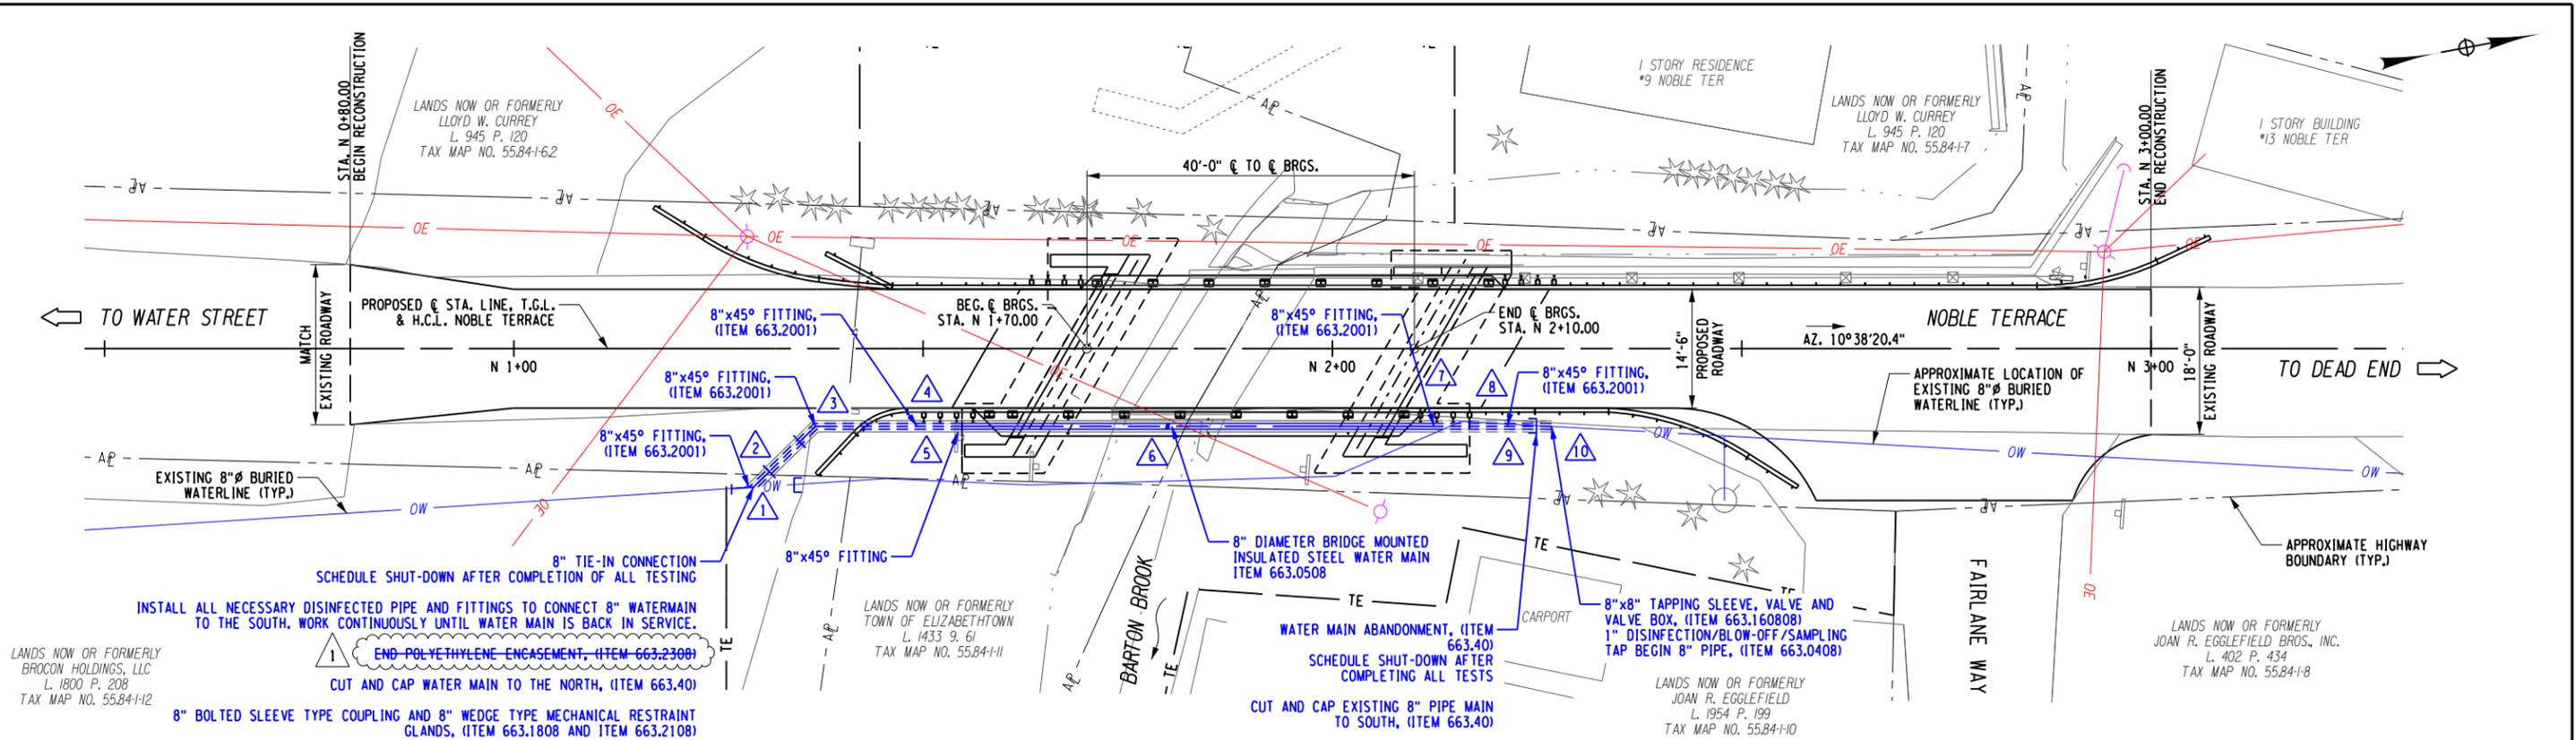

WATER MAIN NOTES:

1. INSTALL NEW WATER MAIN WITH A MINIMUM OF 5'-6" OF COVER FROM FINAL PROJECT GRADES.
2. WATER PRESSURE TEST IS REQUIRED UPON COMPLETION OF THE INSTALLATION AND BACKFILL OF THE WATER MAIN, UNLESS OTHERWISE NOTED, A MINIMUM HYDROSTATIC PRESSURE OF 150 PSI IS REQUIRED. NO PRESSURE DROP IS ALLOWED. THE PRESSURE TEST MUST BE MAINTAINED FOR A PERIOD OF ONE HOUR WITHOUT ADDITIONAL PUMPING OR ADDITION OF WATER.
3. FLUSHING, DISINFECTING AND HEALTH SAMPLING ARE REQUIRED FOR ALL WATER MAIN WORK WHERE MORE THAN 19' OF WATER MAIN AND APPURTENANCES ARE INSTALLED. FOR WORK WHERE 19' OR LESS ARE INSTALLED, THE INTERIOR OF ALL PIPE, FITTINGS AND APPURTENANCES SHALL BE SWAB-DISINFECTED WITH A 5% SODIUM HYPOCHLORITE SOLUTION. THE SOLUTION MUST BE APPLIED USING A WIDE BRUSH OR SPRAYER NO MORE THAN 60 MINUTES AND NO LESS THAN 20 MINUTES PRIOR TO INSTALLATION.
4. THE WATER MAIN SHALL NOT BE PLACED INTO SERVICE UNTIL SO AUTHORIZED IN WRITING BY THE COUNTY HEALTH DEPARTMENT AND TOWN OF ELIZABETHTOWN.
5. WATER MAINS AND APPURTENANCES TO BE CONSTRUCTED IN ACCORDANCE WITH THE REGULATIONS AND SPECIFICATIONS OF THE TOWN OF ELIZABETHTOWN.
6. WATER MAINS SHALL BE 8 INCH POLYVINYL CHLORIDE (PVC) PIPE CONFORMING TO ANWA C-900, MINIMUM CLASS 200 (DR14) WITH ELASTOMERIC GASKET JOINTS AND INTEGRAL BELL AND RUBBER RINGS LOCKED IN PLACE. WATER MAINS SHALL BE 8 INCH DUCTILE IRON, CEMENT-LINED, CLASS 52 WITH ZINC COATING.
 PVC WATER MAIN INSTALLATION SHALL INCLUDE:
 A. 6 INCH WIDE METALLIC TAPE PLACED OVER THE CENTER OF THE PIPE ON TOP OF THE 18 INCH SAFETY COVER AS MANUFACTURED BY LINE GUARD III, INC.
 B. #10 GAUGE COPPER WIRE ATTACHED TO THE PIPE AT 5 FOOT INTERVALS WITH PLASTIC TIES WITH A MINIMUM OF 150 LBS TENSILE STRENGTH. WIRE SHALL BE ATTACHED TO ALL CAST FITTINGS, HYDRANTS AND VALVE BOXES TO MAKE A CONTINUOUS TRACEABLE SYSTEM. COST TO BE INCLUDED IN THE PRICE BID FOR VARIOUS WATER MAIN ITEMS.

WATER MAIN RELOCATION PLAN

7. WATER SERVICE(S) SHALL BE MINIMUM 1 INCH TYPE K COPPER FROM THE WATER MAIN TO THE CURB BOX. COST TO BE INCLUDED IN THE PRICE BID FOR VARIOUS WATER MAIN ITEMS.
8. ALL GATE VALVES SHALL BE EPOXY-COATED AND HAVE STAINLESS STEEL BODY AND BONNET BOLTS. - ALL NEW WATER MAINS SHALL INCLUDE V-BIO ENHANCED POLYETHYLENE ENCASEMENT.
8. THE CONTRACTOR IS RESPONSIBLE TO SCHEDULE ALL WATER MAIN TAPS WITH THE TOWN OF ELIZABETHTOWN, IN WRITING, A MINIMUM OF THREE WORK DAYS IN ADVANCE. THE CONTRACTOR IS REQUIRED TO PROVIDE SAFE EXCAVATION (INCLUDING ACCESS) AND SUPPLY AND INSTALL THE TAPPING SLEEVE AND VALVE SUCH THAT IT WILL PASS AN AIR TEST ADMINISTERED BY THE TOWN OF ELIZABETHTOWN PRIOR TO MAKING THE TAP.
9. MINIMUM HORIZONTAL SEPARATION BETWEEN WATER MAINS AND SEWER MAINS SHALL BE 10 FEET. MINIMUM VERTICAL SEPARATION BETWEEN WATER MAINS AND SEWER MAINS SHALL BE 18 INCHES MEASURED FROM THE OUTSIDE OF THE PIPES AT THE POINT OF CROSSING. ONE FULL LENGTH OF WATER MAIN SHALL BE CENTERED UNDER OR OVER THE SEWER SO THAT BOTH JOINTS WILL BE AS FAR FROM THE SEWER AS POSSIBLE. WHERE A WATER MAIN CROSSES UNDER A SEWER, ADEQUATE STRUCTURAL SUPPORT (COMPACTED SELECT GRANULAR FILL) SHALL BE PROVIDED FOR THE SEWER TO PREVENT EXCESSIVE DEFLECTION OF JOINTS AND SETTLING OF THE SEWER ON THE WATER MAIN.
10. DUCTILE IRON FITTINGS SHALL MEET ANWA C-111 SPECIFICATIONS, MINIMUM CLASS 250, WITH MECHANICAL OR PUSH-ON JOINT, EXCEPT FOR HYDRANT BRANCHES, WHICH SHALL BE MECHANICAL JOINT. FITTINGS SHALL BE CEMENT LINED IN ACCORDANCE WITH ANWA C-104. BOLTS AND NUTS SHALL BE HIGH-STRENGTH, LOW ALLOY, COATED STEEL. PVC FITTINGS SHALL MEET SPECIFICATIONS OF ANWA C-905 MADE FROM PVC COMPOUND 12454-8 (ASTM D1784) WITH GASKET JOINTS MEETING ASTM D3139. ALL FITTINGS SHALL BE BACKED WITH ADEQUATELY-SIZED 2500 PSI MINIMUM STRENGTH CONCRETE THRUST BLOCKS CONTAINING NO FLY ASH OR POZZOLANS. CONCRETE FOR THRUST BLOCKS MUST BE TRANSIT MIX.
11. THE CONTRACTOR SHALL NOTIFY THE TOWN OF ELIZABETHTOWN SUPERVISOR, CATHLEEN REUSSER 518-873-6555 AND THE SUPERINTENDENT OF THE DEPARTMENT OF PUBLIC WORKS JACK PULSIFER 518-618-5872, A MINIMUM OF THREE WORK DAYS PRIOR TO STARTING ANY WATER MAIN WORK.
12. CONTRACTOR IS RESPONSIBLE FOR VERIFYING SIZE OF EXISTING WATER MAIN(S) PRIOR TO SCHEDULING ANY WET TAPS OR SHUTDOWNS FOR TIE-IN CONNECTIONS. CONTRACTOR MUST HAVE ALL NECESSARY MATERIALS ONSITE PRIOR TO ANY WATER SYSTEM SHUTDOWNS FOR TIE-IN CONNECTIONS.
13. IF ANY CONTACT IS MADE WITH TOWN OF ELIZABETHTOWN FACILITIES OR IF ANY PROBLEMS WITH EXISTING WATER MAINS OR APPURTENANCES OCCUR DURING CONSTRUCTION, NOTIFY THE TOWN OF ELIZABETHTOWN DEPARTMENT OF PUBLIC WORKS AT 518-618-5872.
14. ALL WATER SYSTEM HYDRANTS, VALVES AND CURB BOXES SHALL BE ADJUSTED TO GRADE AND MAINTAINED ACCESSIBLE THROUGHOUT THE PROJECT.
15. THE CONTRACTOR IS RESPONSIBLE TO SCHEDULE AND COORDINATE ALL REQUIRED WATER SYSTEM SHUT-OFFS, INCLUDING A MINIMUM 24 HOUR ADVANCE WRITTEN NOTICE TO ALL AFFECTED CUSTOMERS AND A MINIMUM OF 3 WORK DAYS ADVANCE WRITTEN NOTICE TO THE TOWN OF ELIZABETHTOWN. WATER SYSTEM SHUT-OFF NOTIFICATIONS SHALL INCLUDE THE FOLLOWING INFORMATION (LOCATION, DATE, TIME OF SHUT-OFF, DURATION, ANTICIPATED TIME OF TURN ON AND NUMBER OF AFFECTED CUSTOMERS). ALL EXISTING WATER SYSTEM VALVES AND APPURTENANCES ARE TO BE OPERATED BY TOWN PERSONNEL ONLY. NO WATER SYSTEM SHUT-OFFS WILL BE ALLOWED ON TOWN HOLIDAYS.
16. THE CONTRACTOR SHALL USE CAUTION WHEN WORKING IN THE VICINITY OF EXISTING WATER MAINS (INCLUDING THE USE OF COMPACTION EQUIPMENT). ANY DAMAGE TO TOWN OF ELIZABETHTOWN FACILITIES THAT IS DUE TO THE CONTRACTOR'S OPERATIONS WILL BE REPAIRED AT THE CONTRACTOR'S EXPENSE.
17. MAXIMUM TIME ALLOWED FOR ANY WATER MAIN SHUT DOWN SHALL BE FOUR (4) HOURS.
18. THE CONTRACTOR IS RESPONSIBLE TO SCHEDULE ALL REQUIRED WATERING UP, FLUSHING AND TESTING OF THE NEW WATER MAIN VIA WRITTEN NOTICE TO THE TOWN OF ELIZABETHTOWN A MINIMUM OF 3 WORK DAYS IN ADVANCE. ALL EXISTING WATER SYSTEM VALVES AND APPURTENANCES ARE TO BE OPERATED BY TOWN PERSONNEL ONLY.
19. ALL OPEN PIPE ENDS ON WATER MAIN AND APPURTENANCES SHALL BE COVERED IN A WATER-TIGHT MANNER USING TEMPORARY CAPS, PLUGS OR DOUBLE-LAYERED PLASTIC SHEETING. THIS REQUIREMENT APPLIES TO PIPE THAT IS BEING SHIPPED, STOCKPILED, STAGED, STRUNG ALONG THE JOBSITE OR WITHIN EXCAVATIONS DURING INSTALLATION. ALL DIRT, DEBRIS AND FOREIGN MATERIALS MUST BE REMOVED FROM THE INSIDE OF NEW WATER MAIN AND APPURTENANCES PRIOR TO INSTALLATION.
20. THE EXCAVATION WATER LEVEL SHALL BE KEPT A MINIMUM OF 12 INCHES BELOW THE WATER MAIN INVERT DURING INSTALLATION.
21. ALL VALVES ON ABANDONED SECTIONS OF WATER MAIN SHALL BE LEFT IN THE CLOSED POSITION AND THE VALVE BOX SHALL BE REMOVED.
22. THE USE OF RECYCLED CONCRETE AS BACKFILL MATERIAL IS NOT ALLOWED UNLESS IT HAS BEEN CONFIRMED THAT THE RECYCLED CONCRETE CONTAINS NO FLY-ASH OR POZZOLANS. SUFFICIENT TESTS SHALL BE PERFORMED BY A CERTIFIED TESTING LABORATORY (AT THE CONTRACTOR'S EXPENSE) TO DETERMINE THAT EACH SOURCE OF RECYCLED CONCRETE CONTAINS NO FLY-ASH OR POZZOLANS.
23. CONTRACTOR MUST SUBMIT A WRITTEN REQUEST FOR THE TOWN OF ELIZABETHTOWN TO CHECK ALL VALVES AND HYDRANTS A MINIMUM OF 3-4 WEEKS PRIOR TO START OF PROJECT, AND AT END OF PROJECT, AS PART OF THE PRE-PROJECT VALVE CHECKS, THE TOWN WILL CORRECT ANY DEFICIENCIES FOUND BEFORE THE PROJECT BEGINS. AT END OF PROJECT, THE TOWN WILL CHECK ALL VALVES AND HYDRANTS AND PROVIDE CONTRACTOR WITH A WRITTEN PUNCHLIST OF ITEMS TO BE CORRECTED.
24. IF ANY OUT-OF-SERVICE WATER LINES ARE EXPOSED DURING STRUCTURAL EXCAVATION, REMOVAL TO BE INCLUDED UNDER ITEM 206.01, STRUCTURE EXCAVATION.


PAYMENT NOTE:

1. ALL ITEM NUMBERS SHOWN IN PARENTHESIS HAVE BEEN SHOWN FOR SPECIFICATION PURPOSES. ALL WORK FOR THE WATER LINE INSTALLATION SHALL BE PAID FOR UNDER "8" DIAMETER BRIDGE MOUNTED STEEL WATER MAIN", ITEM 663.0508.

LEGEND:

X - WW NUMBER, SEE WATERWORKS TABLE, DWG. ST-20

PREPARED BY: CHARLES TUTUNJIAN, P.E. ON: 02/10/2026
 ALTERED BY: CHARLES TUTUNJIAN, P.E. ON: 03/02/2026

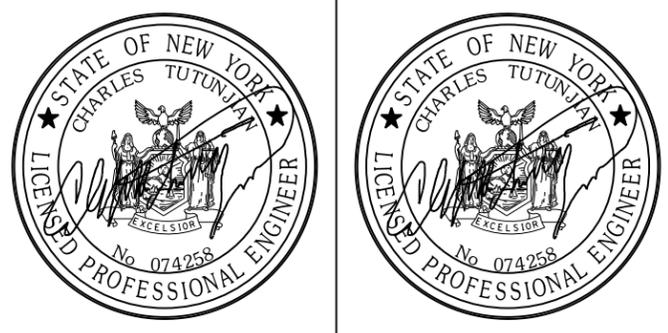


AS-BUILT REVISIONS DESCRIPTION OF ALTERATIONS:	NOBLE TERRACE OVER BARTON BROOK	BRIDGES BIN TBD	CULVERTS	ALL DIMENSIONS IN FT UNLESS OTHERWISE NOTED	CONTRACT NUMBER DR 4814
	CULVERT REPLACEMENT PROJECT				PROJECT NUMBER: 766429
	TOWN OF ELIZABETHTOWN				DRAWING NO. ST-19
	COUNTY: ESSEX	REGION: 1			SHEET NO. 24


IT IS A VIOLATION OF LAW FOR ANY PERSON, UNLESS THEY ARE ACTING UNDER THE DIRECTION OF A LICENSED PROFESSIONAL ENGINEER, ARCHITECT, LANDSCAPE ARCHITECT, OR LAND SURVEYOR, TO ALTER AN ITEM IN ANY WAY. IF AN ITEM BEARING THE STAMP OF A LICENSED PROFESSIONAL IS ALTERED, THE ALTERING ENGINEER, ARCHITECT, LANDSCAPE ARCHITECT, OR LAND SURVEYOR SHALL STAMP THE DOCUMENT AND INCLUDE THE NOTATION "ALTERED BY" FOLLOWED BY THEIR SIGNATURE, THE DATE OF SUCH ALTERATION, AND A SPECIFIC DESCRIPTION OF THE ALTERATION.



PROJECT MANAGER: C. TUTUNJIAN
 CHECKED BY: I. PENGU
 DRAFTED BY: C. VICKERY
 CHECKED BY: I. PENGU
 DESIGNED BY: C. VICKERY

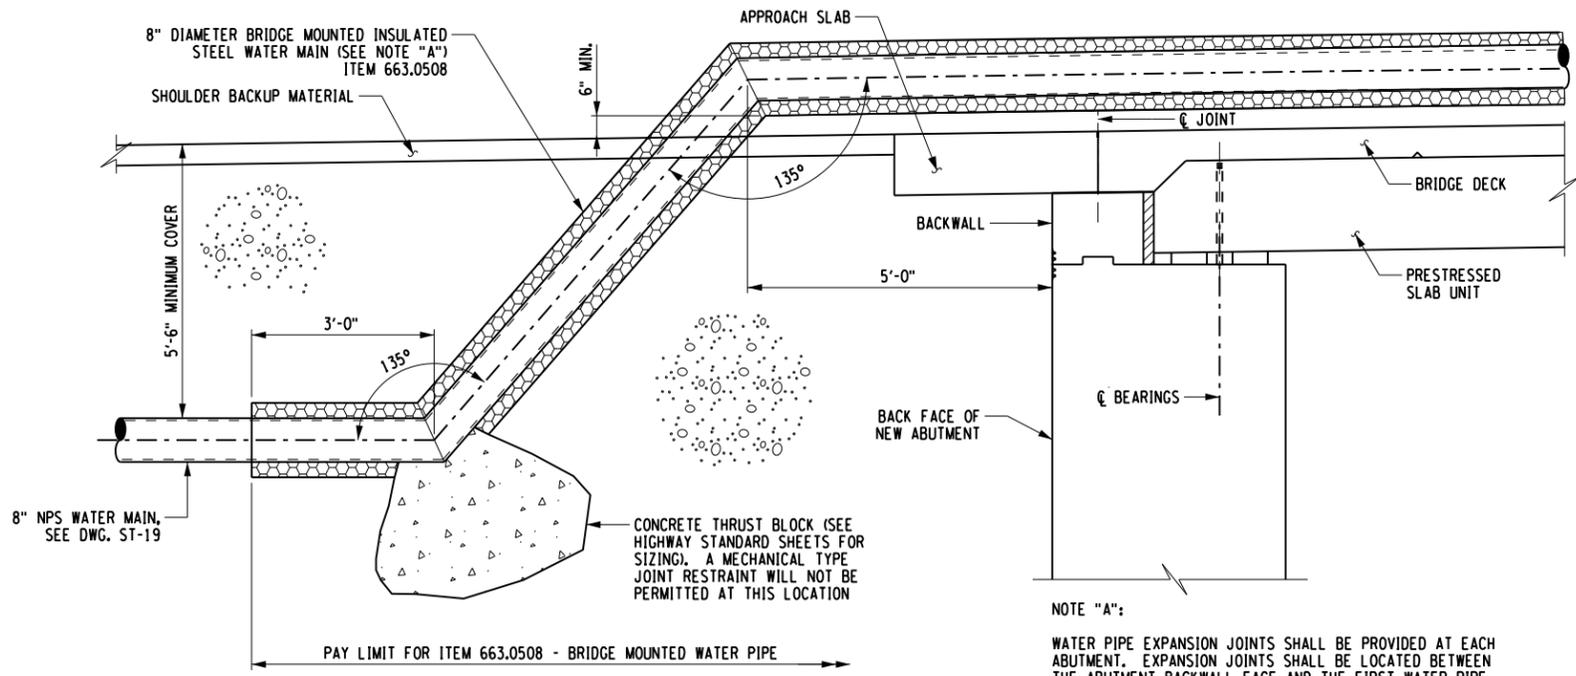

WATER MAIN TERMINATION DETAIL
 (BEGIN ABUTMENT SHOWN - END ABUTMENT SIMILAR)
 NOT TO SCALE

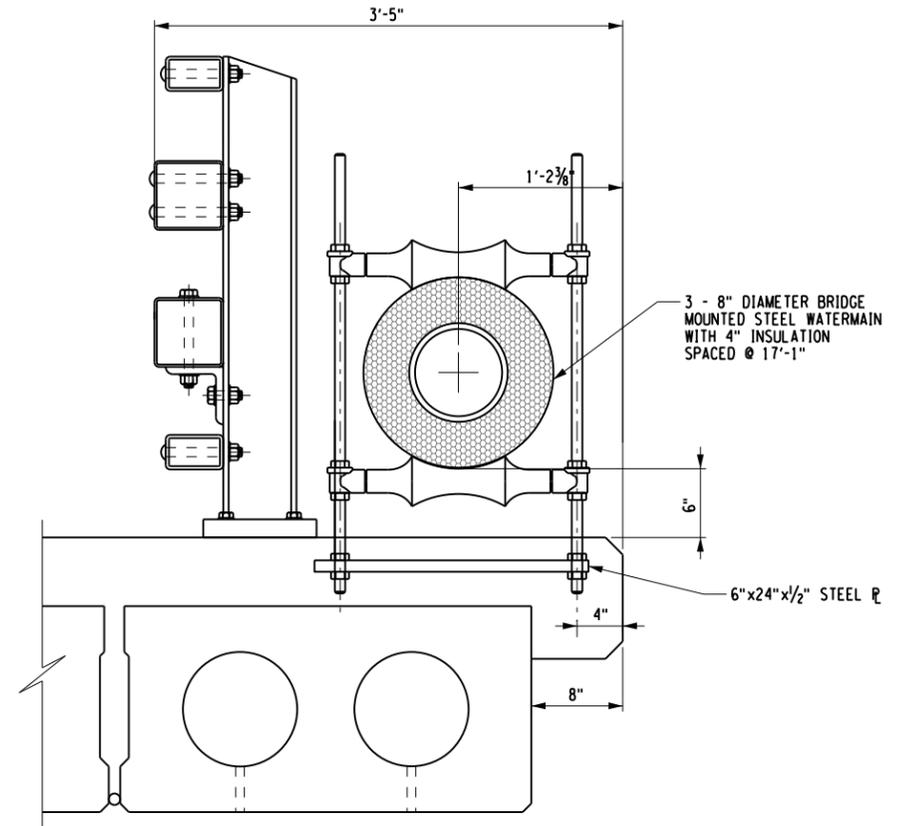

WATER MAIN NOTE:
 THE COST OF INSULATED WATER PIPE AND SUPPORTS (INCLUDING CONTINUOUS THREADED ROD, SOCKETS, CAST IRON PIPE ROLLS AND ASSOCIATED HARDWARE) SHALL BE INCLUDED IN THE UNIT PRICE BID FOR ITEM 663.0508 - BRIDGE MOUNTED WATER PIPE.

UTILITY ON BRIDGE TYPICAL SECTION
 SCALE: 3/4" = 1'-0"

WATERWORKS TABLE**									
WW NUMBER	LOCATION	STATION	OFFSET (FT)	SIDE	TO	STATION	OFFSET (FT)	SIDE	DESCRIPTION
1	NOBLE TERRACE	N 1+28.72	16.9	RIGHT	-	N 1+29.26	16.9	RIGHT	8" TIE-IN CONNECTION, SCHEDULE SHUT-DOWN AFTER COMPLETION OF ALL TESTING INSTALL ALL NECESSARY DISINFECTED PIPE & FITTINGS TO CONNECT 8" WATER MAIN TO THE SOUTH END POLYETHYLENE ENCASEMENT CUT & CAP WATER MAIN TO THE NORTH 8" BOLTED SLEEVE TYPE COUPLING & 8" WEDGE TYPE MECHANICAL RESTRAINT GLANDS
2	NOBLE TERRACE	N 1+29.26	16.8	RIGHT	-	N 1+29.26	16.8	RIGHT	8"x45° FITTING
-	NOBLE TERRACE	N 1+29.26	16.8	RIGHT	-	N 1+36.84	9.5	RIGHT	8" DIAMETER INSULATED STEEL WATER MAIN - LENGTH = 5'-3"
3	NOBLE TERRACE	N 1+36.84	9.5	RIGHT	-	N 1+36.84	9.5	RIGHT	8"x45° FITTING
-	NOBLE TERRACE	N 1+36.84	9.5	RIGHT	-	N 1+43.90	9.5	RIGHT	8" DIAMETER INSULATED STEEL WATER MAIN - LENGTH = 9'-9"
4	NOBLE TERRACE	N 1+43.90	9.5	RIGHT	-	N 1+43.90	9.5	RIGHT	8"x45° FITTING
-	NOBLE TERRACE	N 1+43.90	9.5	RIGHT	-	N 1+54.25	9.5	RIGHT	8" DIAMETER INSULATED STEEL WATER MAIN - LENGTH = 7'-9"
5	NOBLE TERRACE	N 1+54.25	9.5	RIGHT	-	N 1+54.25	9.5	RIGHT	8"x45° FITTING
6	NOBLE TERRACE	N 1+62.88	9.5	RIGHT	-	N 2+05.98	9.5	RIGHT	8" DIAMETER BRIDGE MOUNTED INSULATED STEEL WATER MAIN - LENGTH = 55'-6"
7	NOBLE TERRACE	N 2+12.41	9.5	RIGHT	-	N 2+12.41	9.5	RIGHT	8"x45° FITTING
-	NOBLE TERRACE	N 2+12.41	9.5	RIGHT	-	N 2+21.38	9.5	RIGHT	8" DIAMETER INSULATED STEEL WATER MAIN - LENGTH = 7'-9"
8	NOBLE TERRACE	N 2+21.38	9.5	RIGHT	-	N 2+21.38	9.5	RIGHT	8"x45° FITTING
9	NOBLE TERRACE	N 2+24.92	9.5	RIGHT	-	N 2+24.92	9.5	RIGHT	WATER MAIN ABANDONMENT, SCHEDULE SHUT-DOWN AFTER COMPLETING ALL TESTS CUT & CAP EXISTING 8" PIPE MAIN TO SOUTH
10	NOBLE TERRACE	N 2+26.78	9.5	RIGHT	-	N 2+26.78	9.5	RIGHT	8"x8" TAPPING SLEEVE, VALVE & VALVE BOX 1" DISINFECTION/BLOW-OFF/SAMPLING TAP BEGIN 8" PIPE

** ALL ITEM NUMBERS SHOWN IN (PARENTHESES) ARE SHOWN FOR SPECIFICATION PURPOSES. ALL WORK FOR THE WATER LINE INSTALLATION SHALL BE PAID FOR UNDER ITEM 663.0508

PREPARED BY: CHARLES TUTUNJIAN, P.E. ON: 02/10/2026
 ALTERED BY: CHARLES TUTUNJIAN, P.E. ON: 03/02/2026



AS-BUILT REVISIONS DESCRIPTION OF ALTERATIONS:	NOBLE TERRACE OVER BARTON BROOK	BRIDGES BIN TBD	CULVERTS	ALL DIMENSIONS IN FT UNLESS OTHERWISE NOTED	CONTRACT NUMBER DR 4814
	CULVERT REPLACEMENT PROJECT				PROJECT NUMBER: 766429
	TOWN OF ELIZABETH TOWN			WATER MAIN DETAILS - 1	DRAWING NO. ST-20
	COUNTY: ESSEX REGION: 1				SHEET NO. 25

IT IS A VIOLATION OF LAW FOR ANY PERSON, UNLESS THEY ARE ACTING UNDER THE DIRECTION OF A LICENSED PROFESSIONAL ENGINEER, ARCHITECT, LANDSCAPE ARCHITECT, OR LAND SURVEYOR, TO ALTER AN ITEM IN ANY WAY. IF AN ITEM BEARING THE STAMP OF A LICENSED PROFESSIONAL IS ALTERED, THE ALTERING ENGINEER, ARCHITECT, LANDSCAPE ARCHITECT, OR LAND SURVEYOR SHALL STAMP THE DOCUMENT AND INCLUDE THE NOTATION "ALTERED BY" FOLLOWED BY THEIR SIGNATURE, THE DATE OF SUCH ALTERATION, AND A SPECIFIC DESCRIPTION OF THE ALTERATION.